Attachment C

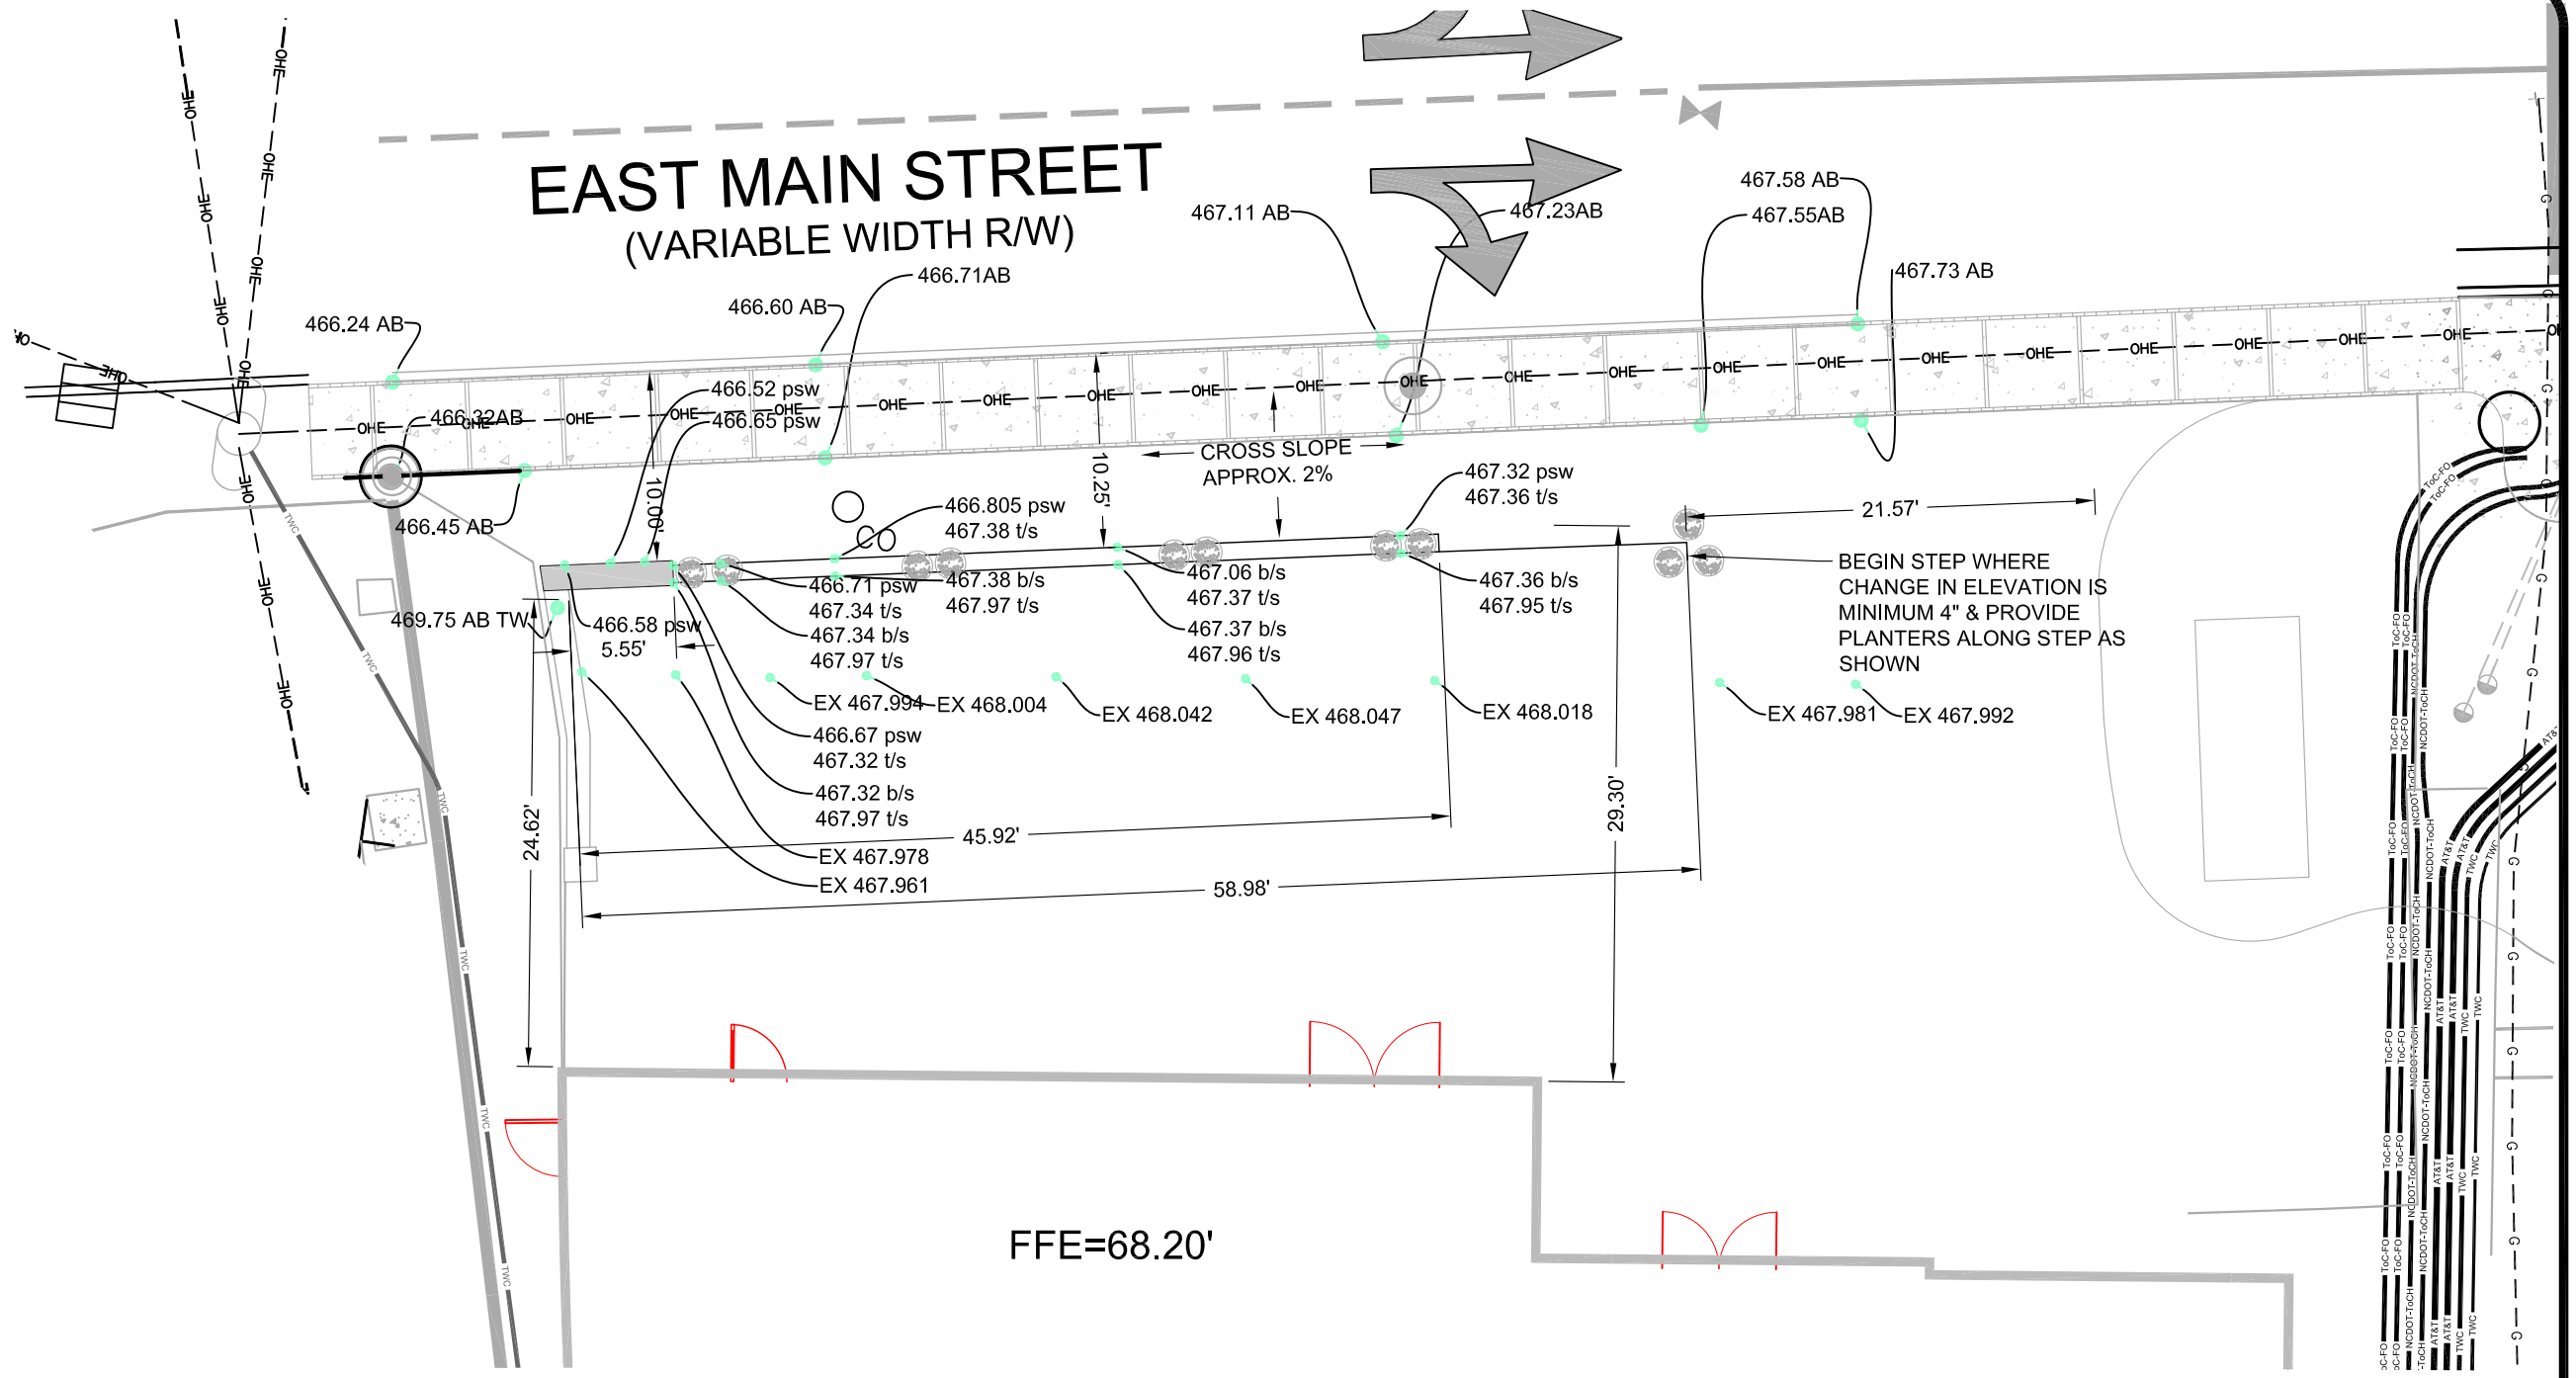

KEY
AB - ASBUILT
T/S - TOP OF STEP
B/S - BOTTOM OF STEP
PSW - PROPOSED SIDEWALK
TW- TOP OF WALL

GRAPHIC SCALE
5 0 2.5 5 10 20
(IN FEET)
1 inch = 10 ft.

SCALE
1"=10'

FIRST ISSUE DATE
01/29/2015

PROJECT NO.
13-0160

SHEET NO.
BULLETIN

COPYRIGHT © 2014
SUMMIT DESIGN AND
ENGINEERING SERVICES
DRAWING ALTERATION
IT IS A VIOLATION OF LAW FOR ANY PERSON, UNLESS ACTING UNDER THE DIRECTION OF LICENSED ARCHITECT, PROFESSIONAL ENGINEER, LANDSCAPE ARCHITECT, OR LAND SURVEYOR TO ALTER ANY ITEM ON THIS DOCUMENT IN ANY WAY. ANY LICENSEE WHO ALTERS THIS DOCUMENT IS REQUIRED BY LAW TO AFFIX HIS OR HER SEAL AND THE NOTATION "ALTERED BY" FOLLOWED BY HIS OR HER SIGNATURE AND SPECIFIC DESCRIPTION OF THE ALTERATIONS.

300 EAST MAIN STREET
PHASE A & B

310 EAST MAIN STREET
CARRBORO, NC

WALL DETAILS
EAST MAIN & LLOYD STREET INTERSECTION

SUMMIT
DESIGN AND ENGINEERING SERVICES
Creatively Inspired - Technically Executed
License #: P-0339
504 Meadowland Drive
Hillsborough, NC 27278-8551
Voice: (919) 732-3883 Fax: (919) 732-6676
www.summit-engineer.com

K:\2013\13-0160\Civil\Construction\As-Builts\2015-05-22 As-built_Wall Exhibit\13-0160 G-1 WALL EXHIBITS Asbuilt CU.dwg, 2015-08-17 Wall Exhibit, 8/24/2015 2:58:56 PM, kellysue.woody, 1:1